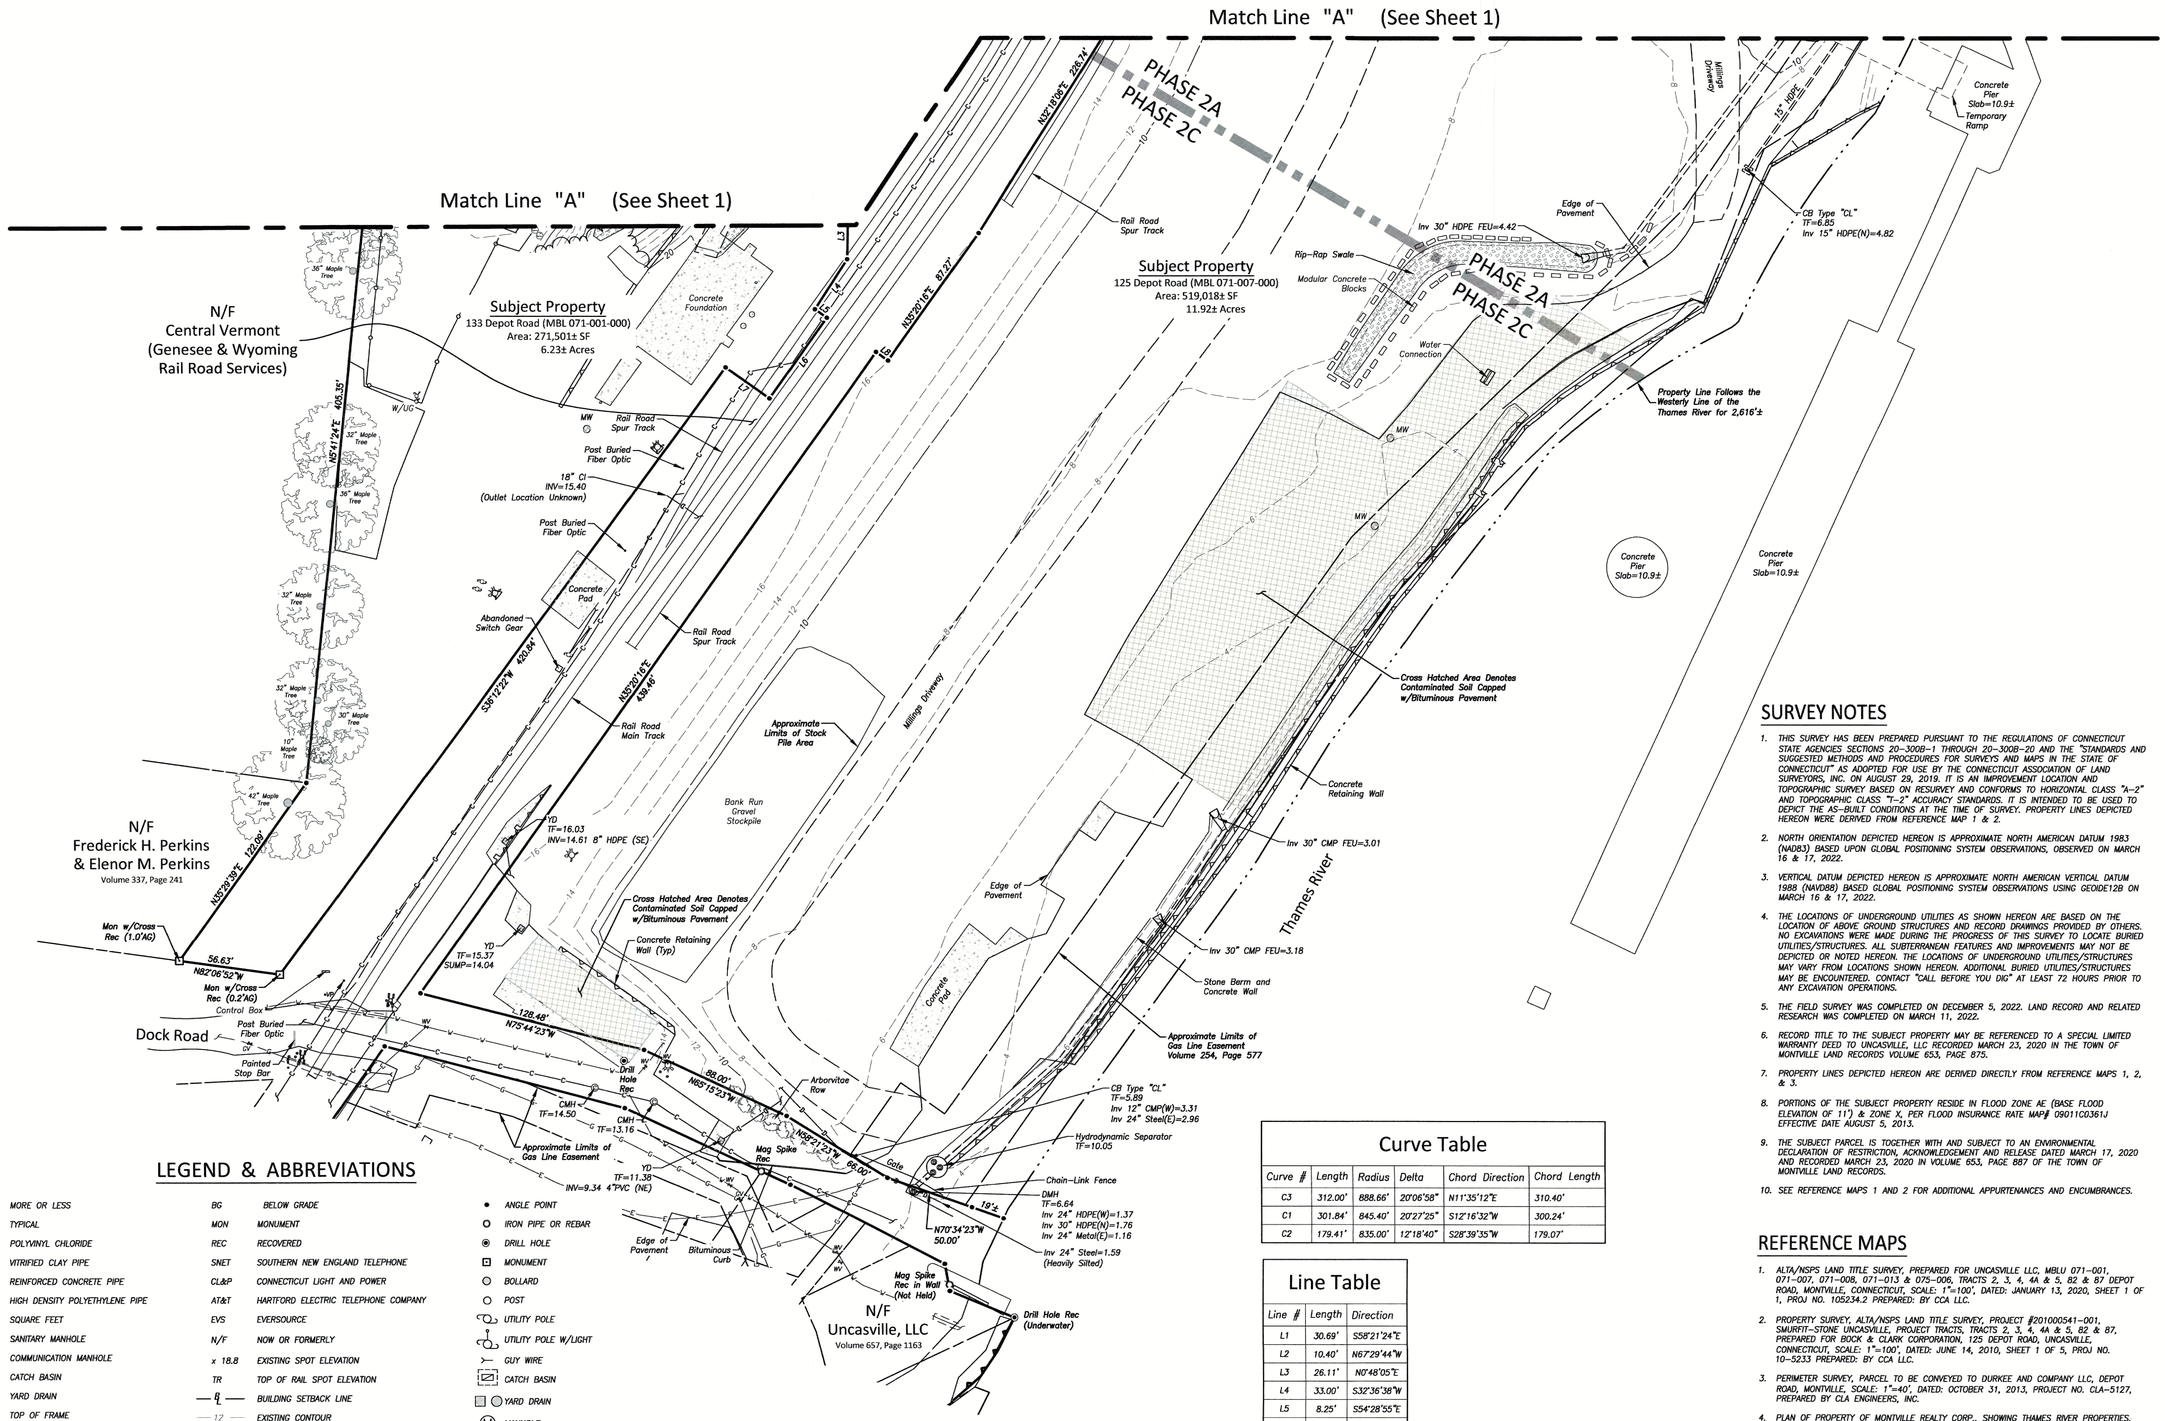

LEGEND & ABBREVIATIONS

±	MORE OR LESS	BG	BELOW GRADE
TYP	TYPICAL	MON	MONUMENT
PVC	POLYVINYL CHLORIDE	REC	RECOVERED
VCP	VITRIFIED CLAY PIPE	SNET	SOUTHERN NEW ENGLAND TELEPHONE
RCP	REINFORCED CONCRETE PIPE	CL&P	CONNECTICUT LIGHT AND POWER
HDPE	HIGH DENSITY POLYETHYLENE PIPE	AT&T	HARTFORD ELECTRIC TELEPHONE COMPANY
SF	SQUARE FEET	EVS	EVERSOURCE
MH	SANITARY MANHOLE	N/F	NOW OR FORMERLY
CMH	COMMUNICATION MANHOLE	x 18.8	EXISTING SPOT ELEVATION
CB	CATCH BASIN	TR	TOP OF RAIL SPOT ELEVATION
YD	YARD DRAIN		BUILDING SETBACK LINE
TF	TOP OF FRAME	12	EXISTING CONTOUR
INV	INVERT		TREE LINE
GV	GAS VALVE		RETAINING WALL
WV	WATER VALVE		STONE WALL
HH	HANDHOLE		OVERHEAD WIRES
MB	MAILBOX	G	GAS
W/	WITH	W	WATER
AG	ABOVE GRade	C	COMMUNICATIONS
			CHAIN LINK FENCE

ANGLE POINT
IRON PIPE OR REBAR
DRILL HOLE
MONUMENT
BOLLARD
POST
UTILITY POLE
UTILITY POLE W/LIGHT
GUY WIRE
CATCH BASIN
YARD DRAIN
MANHOLE
COMMUNICATIONS MANHOLE
WATER OR GAS VALVE
MW MONITORING WELL
FMIP FIRE MAIN INDICATOR POST
SIGN
DECIDUOUS TREE
CONIFER TREE

GRAPHIC SCALE

80 40 20 0 40

(IN FEET)
1 inch = 40 ft.

© 2022 BOUNDARIES LLC
THIS DRAWING IS THE PROPERTY OF BOUNDARIES LLC AND HAS BEEN SPECIFICALLY PREPARED FOR THE OWNER OF THIS PROJECT, AT THIS SITE, AND IS NOT TO BE DUPLICATED OR USED IN PART OR WHOLE FOR ANY OTHER PURPOSE, PROJECT, LOCATION OR OWNER WITHOUT THE EXPRESSED WRITTEN CONSENT OF BOUNDARIES LLC.

\\192.168.2.3\PROJECTS\CIVIL 3D PROJECTS\2022\22-3140 GATEWAY TERMINAL\DWG\SURVEY\AS-BUILT PLAN.DWG

Curve Table

Curve #	Length	Radius	Delta	Chord Direction	Chord Length
C3	312.00'	888.66'	20°06'58"	N11°35'12"E	310.40'
C1	301.84'	845.40'	20°27'25"	S12°16'32"W	300.24'
C2	179.41'	835.00'	12°18'40"	S28°39'35"W	179.07'

Line Table

Line #	Length	Direction
L1	30.69'	S58°21'24"E
L2	10.40'	N67°29'44"W
L3	26.11'	N0°48'05"E
L4	33.00'	S32°36'38"W
L5	8.25'	S54°28'55"E
L6	55.40'	S35°31'04"W
L7	30.00'	N54°28'56"W
L8	8.25'	S54°27'13"E

SURVEY NOTES

1. THIS SURVEY HAS BEEN PREPARED PURSUANT TO THE REGULATIONS OF CONNECTICUT STATE AGENCIES SECTIONS 20-300B-1 THROUGH 20-300B-20 AND THE "STANDARDS AND SUGGESTED METHODS AND PROCEDURES FOR SURVEYS AND MAPS IN THE STATE OF CONNECTICUT" AS ADOPTED FOR USE BY THE CONNECTICUT ASSOCIATION OF LAND SURVEYORS, INC. ON AUGUST 29, 2019. IT IS AN IMPROVEMENT LOCATION AND TOPOGRAPHIC SURVEY BASED ON RESURVEY AND CONFORMS TO HORIZONTAL CLASS "A-2" AND TOPOGRAPHIC CLASS "T-2" ACCURACY STANDARDS. IT IS INTENDED TO BE USED TO DEPICT THE AS-BUILT CONDITIONS AT THE TIME OF SURVEY. PROPERTY LINES DEPICTED HEREON WERE DERIVED FROM REFERENCE MAP 1 & 2.
2. NORTH ORIENTATION DEPICTED HEREON IS APPROXIMATE NORTH AMERICAN DATUM 1983 (NAD83) BASED UPON GLOBAL POSITIONING SYSTEM OBSERVATIONS, OBSERVED ON MARCH 16 & 17, 2022.
3. VERTICAL DATUM DEPICTED HEREON IS APPROXIMATE NORTH AMERICAN VERTICAL DATUM 1988 (NAVD88) BASED GLOBAL POSITIONING SYSTEM OBSERVATIONS USING GEOIDE12B ON MARCH 16 & 17, 2022.
4. THE LOCATIONS OF UNDERGROUND UTILITIES AS SHOWN HEREON ARE BASED ON THE LOCATION OF ABOVE GROUND STRUCTURES AND RECORD DRAWINGS PROVIDED BY OTHERS. NO EXCAVATIONS WERE MADE DURING THE PROGRESS OF THIS SURVEY TO LOCATE BURIED UTILITIES/STRUCTURES. ALL SUBTERRANEAN FEATURES AND IMPROVEMENTS MAY NOT BE DEPICTED OR NOTED HEREON. THE LOCATIONS OF UNDERGROUND UTILITIES/STRUCTURES MAY VARY FROM LOCATIONS SHOWN HEREON. ADDITIONAL BURIED UTILITIES/STRUCTURES MAY BE ENCOUNTERED. CONTACT "CALL BEFORE YOU DIG" AT LEAST 72 HOURS PRIOR TO ANY EXCAVATION OPERATIONS.
5. THE FIELD SURVEY WAS COMPLETED ON DECEMBER 5, 2022. LAND RECORD AND RELATED RESEARCH WAS COMPLETED ON MARCH 11, 2022.
6. RECORD TITLE TO THE SUBJECT PROPERTY MAY BE REFERENCED TO A SPECIAL LIMITED WARRANTY DEED TO UNCASVILLE, LLC RECORDED MARCH 23, 2020 IN THE TOWN OF MONTVILLE LAND RECORDS VOLUME 653, PAGE 875.
7. PROPERTY LINES DEPICTED HEREON ARE DERIVED DIRECTLY FROM REFERENCE MAPS 1, 2, & 3.
8. PORTIONS OF THE SUBJECT PROPERTY RESIDE IN FLOOD ZONE AE (BASE FLOOD ELEVATION OF 11') & ZONE X, PER FLOOD INSURANCE RATE MAP# 09011C0361J EFFECTIVE DATE AUGUST 5, 2013.
9. THE SUBJECT PARCEL IS TOGETHER WITH AND SUBJECT TO AN ENVIRONMENTAL DECLARATION OF RESTRICTION, ACKNOWLEDGEMENT AND RELEASE DATED MARCH 17, 2020 AND RECORDED MARCH 23, 2020 IN VOLUME 653, PAGE 887 OF THE TOWN OF MONTVILLE LAND RECORDS.
10. SEE REFERENCE MAPS 1 AND 2 FOR ADDITIONAL APPURTENANCES AND ENCUMBRANCES.

REFERENCE MAPS

1. ALTA/NSPS LAND TITLE SURVEY, PREPARED FOR UNCASVILLE LLC, MBLU 071-001, 071-007, 071-008, 071-013 & 075-006, TRACTS 2, 3, 4, 4A & 5, 82 & 87 DEPOT ROAD, MONTVILLE, CONNECTICUT, SCALE: 1"=100', DATED: JANUARY 13, 2020, SHEET 1 OF 1, PROJ NO. 105234.2 PREPARED: BY CCA LLC.
2. PROPERTY SURVEY, ALTA/NSPS LAND TITLE SURVEY, PROJECT #201000541-001, SMURFIT-STONE UNCASVILLE, PROJECT TRACTS, TRACTS 2, 3, 4, 4A & 5, 82 & 87, PREPARED FOR BOCK & CLARK CORPORATION, 125 DEPOT ROAD, UNCASVILLE, CONNECTICUT, SCALE: 1"=100', DATED: JUNE 14, 2010, SHEET 1 OF 5, PROJ NO. 10-5233 PREPARED: BY CCA LLC.
3. PERIMETER SURVEY, PARCEL TO BE CONVEYED TO DURKEE AND COMPANY LLC, DEPOT ROAD, MONTVILLE, SCALE: 1"=40', DATED: OCTOBER 31, 2013, PROJECT NO. CLA-5127, PREPARED BY CLA ENGINEERS, INC.
4. PLAN OF PROPERTY OF MONTVILLE REALTY CORP., SHOWING THAMES RIVER PROPERTIES, TOWN OF MONTVILLE, CONNECTICUT, SCALE: 1"=100', DATED: AUGUST 18, 1972, PREPARED BY: CHANDLER, PALMER & KING.
5. RIGHT OF WAY AND TRACK MAP, NEW LONDON NORTHERN R.R. CO. OPERATED BY THE CENTRAL VERMONT RY. CO. STATION 264+00 TO STATION 316+80, SCALE: 1"=100', DATED: JUNE 30, 1912. MAP V1-6
6. RIGHT OF WAY AND TRACK MAP, NEW LONDON NORTHERN R.R. CO. OPERATED BY THE CENTRAL VERMONT RY. CO. STATION 316+80 TO STATION 369+60, SCALE: 1"=100', DATED: JUNE 30, 1912, MAP V1-7.
7. SITE OPERATIONS/DEVELOPMENT PLAN, PREPARED FOR GATEWAY MONTVILLE, LLC. 125, 131 & 133 DEPOT ROAD AND 55 DOCK ROAD, UNCASVILLE, CONNECTICUT, DATED: MAY 2022, LAST REVISED SEPTEMBER 28, 2022, SHEETS: 1-24, PREPARED BY: BOUNDARIES LLC.
8. BOUNDARY SURVEY PREPARED FOR TOWN OF MONTVILLE, PROPERTY OF ROCKTENN CP, LLC (FIFTH PARCEL), SCALE: 1"=20', DATED: OCTOBER 7, 2019, LAST REVISED FEBRUARY 10, 2020, PREPARED BY CLA ENGINEERS, INC

BOUNDARIES
CIVIL ENGINEERING · LAND SURVEYING · LAND USE PLANNING · GIS SERVICES
Boundaries LLC
179 Packaging River Drive, Griswold, CT 06351
T 860.376.2006 | www.boundariesllc.net

Improvement Location & Topographic Survey
Record As-Built Plan - South

Prepared for
Gateway Montville, LLC

125 Depot Rd (M/B/L 071-007-000), 131 Depot Rd (M/B/L 071-013-000), 133 Depot Rd (M/B/L 071-001-000) and 55 Dock Rd (M/B/L 071-008-000) - Uncasville, Connecticut

SCALE: 1" = 40'
DATE: December 2022
JOB I.D. NO. 22-3140-4

Revisions
Rev 1, Add Phase 2A/2B Area, 4/24/2023
Rev 2, Add Phase 2C/3 Area, 7/25/2023

SHEET NO.
2
3

Dock Road

Painted Stop Bar

SNET 773

S75°37'06"E 138.49'

CMH TF=14.50

CMH TF=13.16

S65°08'06"E 83.98'

Approximate Limits of Gas Line Easement

Bituminous Curb

Mag Spike Rec

S65°08'06"E 17.85'

S82°49'56"E 97.15'

S10°24'21"E 15.43'

Mag Spike Rec in Wall (Not Held)

S87°38'26"E 38.97'

Drill Hole Rec (Underwater)

N/F
Kurt E. Eichelberg &
Sandra J. Eichelberg
Volume 560, Page 999

SNET 2474

Approximate Limits of Underground Utilities Easement (Per Reference Map 1)

Edge of Pavement

Inv 4" PVC=7.47

MW

190.00'

N35°25'54"E 361.00'

N/F
Central Vermont
(Genesee & Wyoming
Rail Road Services)

N/F
Krista M. Strazza
Volume 561, Page 856

Concrete Pad

Concrete Block Retaining Wall

Approximate Limits of Town of Montville Lease Area

Bituminous Parking Area

N/F
Uncasville, LLC
Volume 657, Page 1163

Subject Property
55 Dock Road (MBL 071-008-000)
Area: 107,975± SF
2.48± Acres

SNET 2475

UPOLE W/RISER

S35°08'14"W

Edge Bituminous Driveway

Edge of Pavement

S64°55'54"W 253.41' (Survey Closing Line)

Inv 4" PVC=7.43

S37°28'51"E 40.00'

Approximate Limits of Gas Line Easement

Sign "Interstate Nav Company"

Concrete Pad

Gravel Driveway

Property Line Follows the Westerly Line of the Thames River 250'± (Per Reference Map 1 & 2)

Thames River

Approximate Limits of 10' Wide Right-Of-Way Over Driveway (Per Reference Map 1)

103.34'

S57°56'39"W

Merestone w/Drill Hole Rec (0.5'AG)

Approximate Property Line Per Reference Map 1

Edge of Gravel Driveway

N68°34'36"W 192.92'

81.99'

S51°43'14"W

N/F
Waterfront Realty Inc
Volume 237, Page 531

GRAPHIC SCALE

40 20 10 0 20

(IN FEET)
1 inch = 20 ft.

© 2022 BOUNDARIES LLC
THIS DRAWING IS THE PROPERTY OF BOUNDARIES LLC AND HAS BEEN SPECIFICALLY PREPARED FOR THE OWNER OF THIS PROJECT, AT THIS SITE, AND IS NOT TO BE DUPLICATED OR USED IN PART OR WHOLE FOR ANY OTHER PURPOSE, PROJECT, LOCATION OR OWNER WITHOUT THE EXPRESSED WRITTEN CONSENT OF BOUNDARIES LLC.

\\192.168.2.3\PROJECTS\CIVIL 3D PROJECTS\2022\22-3140 GATEWAY TERMINAL\DWG\SURVEY\AS-BUILT PLAN.DWG

CIVIL ENGINEERING LAND SURVEYING LAND USE PLANNING GIS/LIS SERVICES
BOUNDARIES
Boundaries LLC
179 Pachaug River Drive, Griswold, CT 06351
T 860.376.2006 | www.boundariesllc.net

Improvement Location & Topographic Survey
Record As-Built Plan - Dock Road

Prepared for
Gateway Montville, LLC

125 Depot Rd (M/B/L 071-007-000), 131 Depot Rd (M/B/L 071-013-000), 133 Depot Rd (M/B/L 071-001-000) and 55 Dock Rd (M/B/L 071-008-000) - Uncasville, Connecticut

SCALE: 1" = 20'

DATE: December 2022

JOB I.D. NO. 22-3140-4

Revisions

Rev 1, Add Phase 2A/2B Area, 4/24/2023

Rev 2, Add Phase 2C/3 Area, 7/25/2023

SHEET NO.

3

3

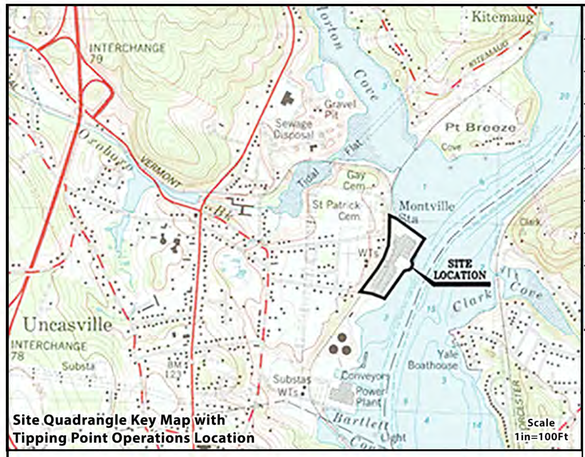

Site Quadrangle Key Map with Tipping Point Operations Location

Operating Capacity		
	Square Feet	Cubic Yards*
Receiving Bin 1	3306	490
Receiving Bin 2	2901	430
Storage Bin 1	10190	1600
Storage Bin 2	8010	1200
Subtotal	24407	3720**

*Assumes 4Ft Depth

**Dry material can be stacked higher in controlled piles to store up to 10,000CY

Equipment List

1. Pneumatic Flow Tube Mixing Tool (PFTM)
2. Mobile Equipment Control Center
3. Mobile Light Stand (typ)
4. Mobile 60 Ton Cement Silo*
5. Mobile Air Compressor *
6. Mobile Cement Batch Plant*
7. Grout Pump
8. 600kW Mobile Generator* (typ)
9. 2000gal cap. Diesel Fuel Above Ground Storage Tank w/ Secondary Containment*
10. 21,000gal Water Storage Frac Tank
11. Sanitary Facilities
12. 2CY MSW Dumpster
13. Field Office
14. Skid Steer (typ)
15. Engineered Fill Storage Area during Curing
16. 22 Ton Tri-Axle Dump Truck
17. Material Handler / Excavator with option for Specialty Mixing Head(typ)
18. Mobile Sediment Materials Conveyor w/ Spill Protection
19. Mobile Bar Screener
20. Mobile Binder Silo
21. Mobile Pugmill
22. High Solids Sediment Pump
23. Placement of Amended Processed Material and Storage for Aggregate
24. Telehandler
25. Engineered Fill Material Curing Bin
26. Oversized Screened rocks, wood, and other dredged material
27. Hopper or Deck Barges
28. Temporary Dock Improvements for Receiving Barges

*Anchored to prevent flotation, collapse or lateral movement of the structure.

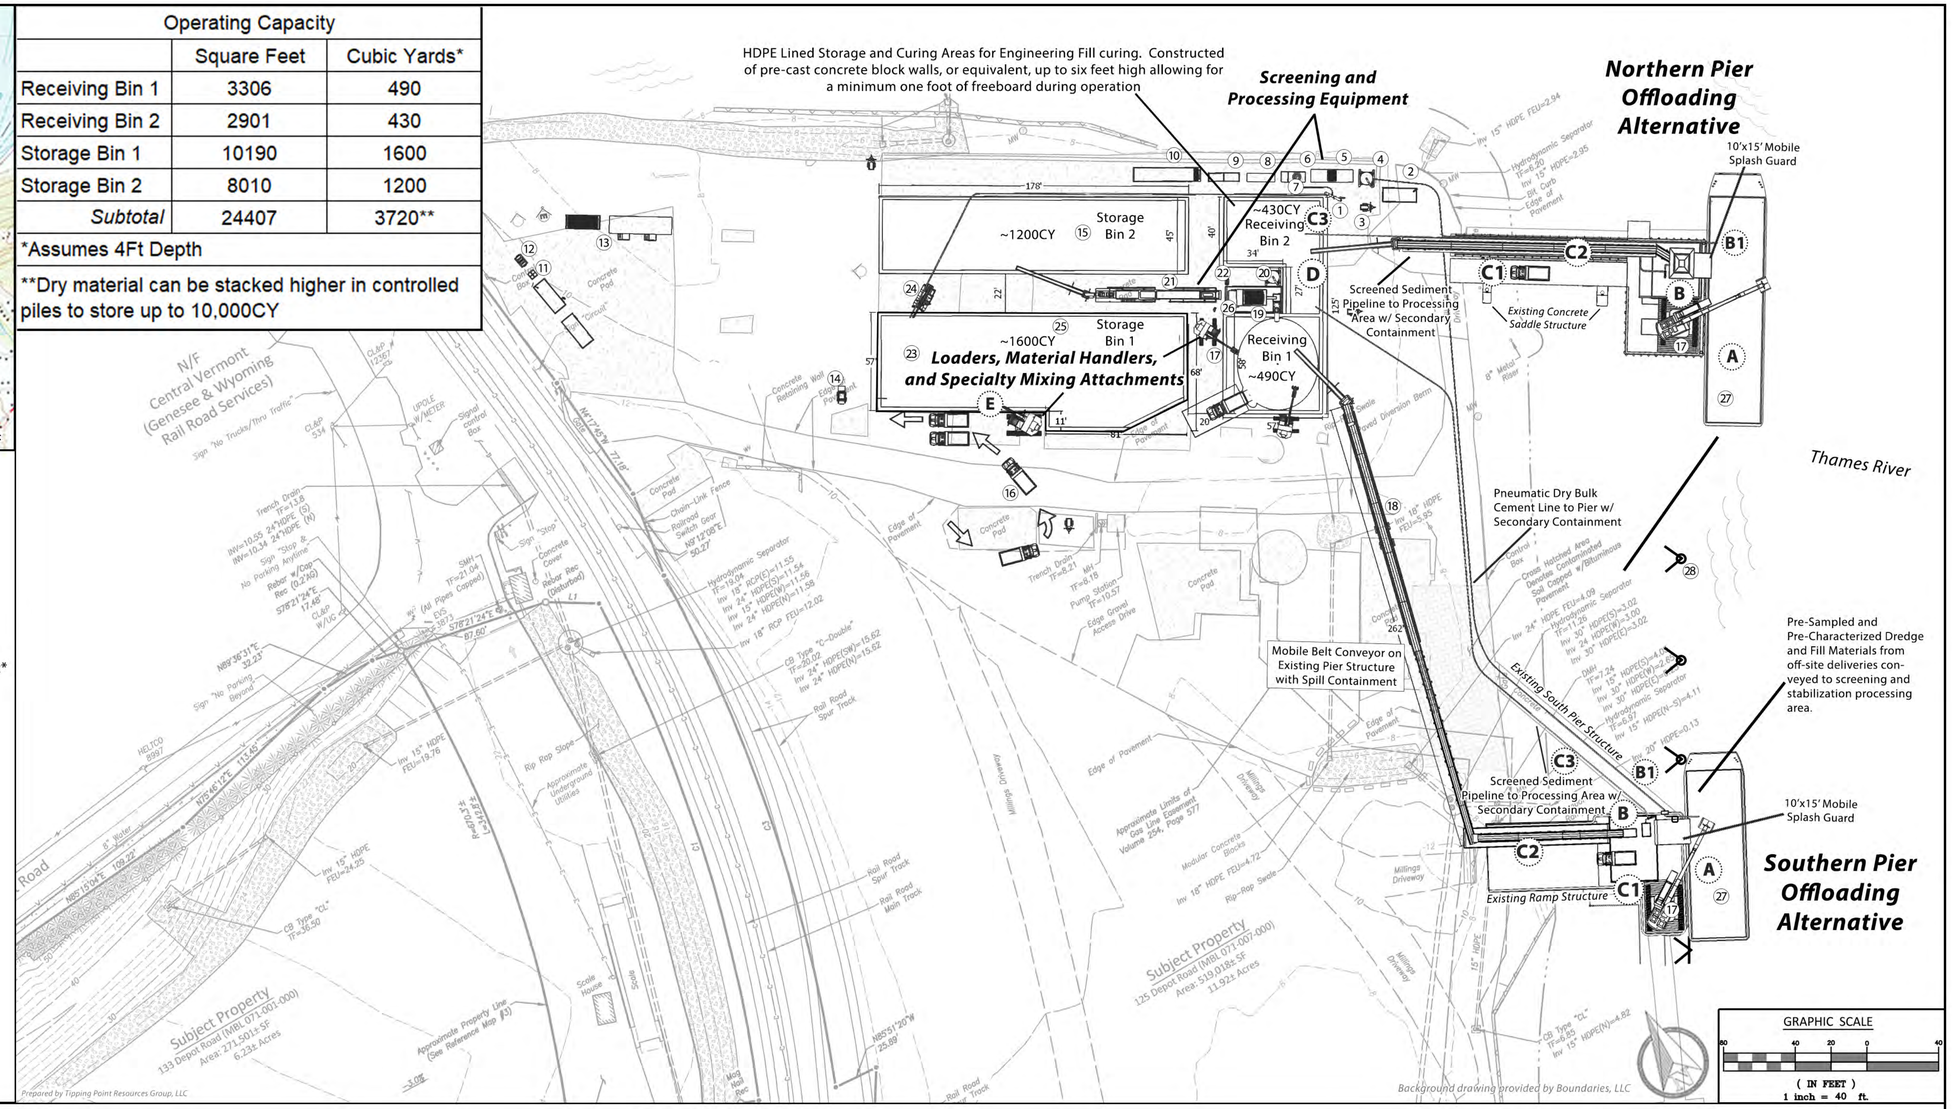

PROJECT NARRATIVE

The proposed project/site operations consist of the intended use of 125 Depot Road for receiving large rock and other construction related aggregate which may include sediment processing to produce engineered fill products from sediments stabilized with Portland cement. Subsequent transloading will take place at the 125 Depot Road that will include offsite transport to the receiving entity. Conversely, water-borne scows may receive construction material for over the water transport.

Typical sources of dredged material/sediment for operations will be as is of poor geotechnical quality. Typically, it is amended with a cementitious product/binder to give it a geotechnical matrix and/or strength. The dredged material will be pre-sampled and analyzed for environmental constituents by a State-certified laboratory. Cement stabilization strengthens and locks together poor-quality material for use as a construction grade material in offsite construction projects, including for capping and regrading. The State of Connecticut Department of Energy and Environmental Protection (CT DEEP) Approval for dredged material management requires pre-characterization of incoming material. Operations at the site will be in accordance with CT-DEEP SWDP Authorization 08601340-DP dated January 2022 for the 125 Depot Road property. No hazardous materials or hazardous wastes will be accepted/handled at the site. All activities will be performed under state and federal compliance as applicable.

Preparation of the Site, including grading and Stormwater Management, was previously approved as Phase 2 of Application #22-SITE-5. No additional earth disturbing activities will be required by the proposed project. 125 Depot Road is intended to be used for the staging and cement mixing/addition to bulk dredged material/sediment which may include aggregates, rock, cement, and brick debris. Trash and other undesirable screened material, such as rebar, wood, etc., will be recycled and/or disposed of offsite according to applicable requirements.

All stormwater runoff from the site will be collected by the approved Stormwater Management System constructed during Phase 2 and treated prior to discharge as previously submitted. When active processing with cement (and subsequent curing) is being performed, stormwater from within the bins will be collected in an onsite frac tank and recycled into the cement batch plant process. A minimum "free-board" of 1 foot will be maintained within the bin walls to allow for the collection of storm water during a rain event.

Set-up for the proposed project is anticipated to start immediately upon Town of Montville Planning and Zoning approval with the receipt of bulk materials to begin immediately following set-up activities.

According to the Natural Resources Conservation Service (NRCS) Web Soil Survey, the soils located on the subject project are 307 Urban Land.

Hours of Operation shall be Monday through Saturday, from 7am to 6pm.

No fixed-permanent equipment is currently proposed. A list of mobile equipment is presented within this application package. Equipment will be fueled by a diesel fuel truck or the proposed onsite 2000-gallon AST and shall be accomplished on impervious surfaces only. One OSHA approved spill kit shall be provided onsite at all times during this operation. Spill protection and containment structures will be deployed as shown in the attached drawing anytime materials are being loaded/offloaded. Any necessary repairs to equipment shall be offsite or be performed utilizing portable containment devices to contain and control any discharges of oils or fluids which may occur during repair. Any such discharges shall be disposed of according to applicable law.

Transportation of materials (raw cement, processed engineered fill, etc.) to/from the site will be via Depot Road to CT Route #32/CT #163. It is anticipated the operation will service between 100,000 and 150,000 tons per year via 22-ton capacity triaxle trucks. Only engineered fill dry enough to meet the CT DOT required "paint filter test" for moisture shall be transported. Average and Peak trucks per day during the winter season are anticipated to be 91 and 120. The peak operating period of the engineered fill production at 125 Depot Road is October to February, with other limited project related work to take place from March through September.

Date
07 September 2023
Version
1.3
Scale
1"=40'

Abutting Properties

49 DOCK RD
Mailing Address: EICHELBERG KURT E & SANDRA J
4 FAWN DR GALES FERRY, CT 06335

POINT BREEZE RD Mailing Address: CV PROPERTIES INCORPORATED PROPERTY TAX PO BOX 8100 DOWNTOWN STATION MONTREAL, QC H3C3N4

DEPOT RD EXT Mailing Address: UNCASVILLE LLC
1515 DES PERES RD ST LOUIS, MO 63131

133 DEPOT RD Mailing Address: UNCASVILLE LLC
1515 DES PERES RD ST LOUIS, MO 63131

General Process Description

A. Secure Hopper Barge to Dock
B. Prepare for Offloading
  Excess Water Management
    B1) Portland Cement Addition
    B2) Pump Water
C. Offloading
  Option C1) Truck Material to Bins
  Option C2) Conveyor Material to Bins
  Option C3) Slurry Pump Material to Bins
D. Stabilize Material with Portland Cement and Cure
E. Load Material and Transport Offsite

Operations Plan Detail

M3 MARINE MATERIALS MANAGEMENT
TIPPING POINT RESOURCES GROUP

STATE OF CONNECTICUT ALFRED N. LOVELL JR. 19765 PROFESSIONAL ENGINEER

Alfred N. Lovell Jr., P.E., LEED AP — 19765 License N0. — 04 September2023 DATE

Stormwater Analysis and Narrative

1) Stormwater Management Report, prepared by Boundaries, LLC dated May 2022.

2) Work to be performed in North Subarea 1, Middle Subarea 1 and CBE Subarea.

3) No increase in impervious areas are proposed.

4) Stormwater runoff from within 24,407 square feet of Storage Bins will be collected and diverted to storage in an onsite 21,000 gallon capacity frac tank. Stormwater will be recycled and used for process water in stabilization treatment.

5) Outfalls 2, 3 and 4 to be protected with existing HydroStorm units for sediment collection. Monitor and maintain according to manufacturer recommendations.

6) Protect swale and down hill areas as shown using 6-inch diameter hay waddles, or equivalent.

7) Deploy 8 inch high secondary containment in transloading areas on dock and ramp.

8) Deploy Best Management Practices for material handling onsite to minimum spillage.
- Inspect and collected spilled sediment minimally daily and more frequently during rain events.
- Storage bins will be maintained with a minimum of 1-foot freeboard.

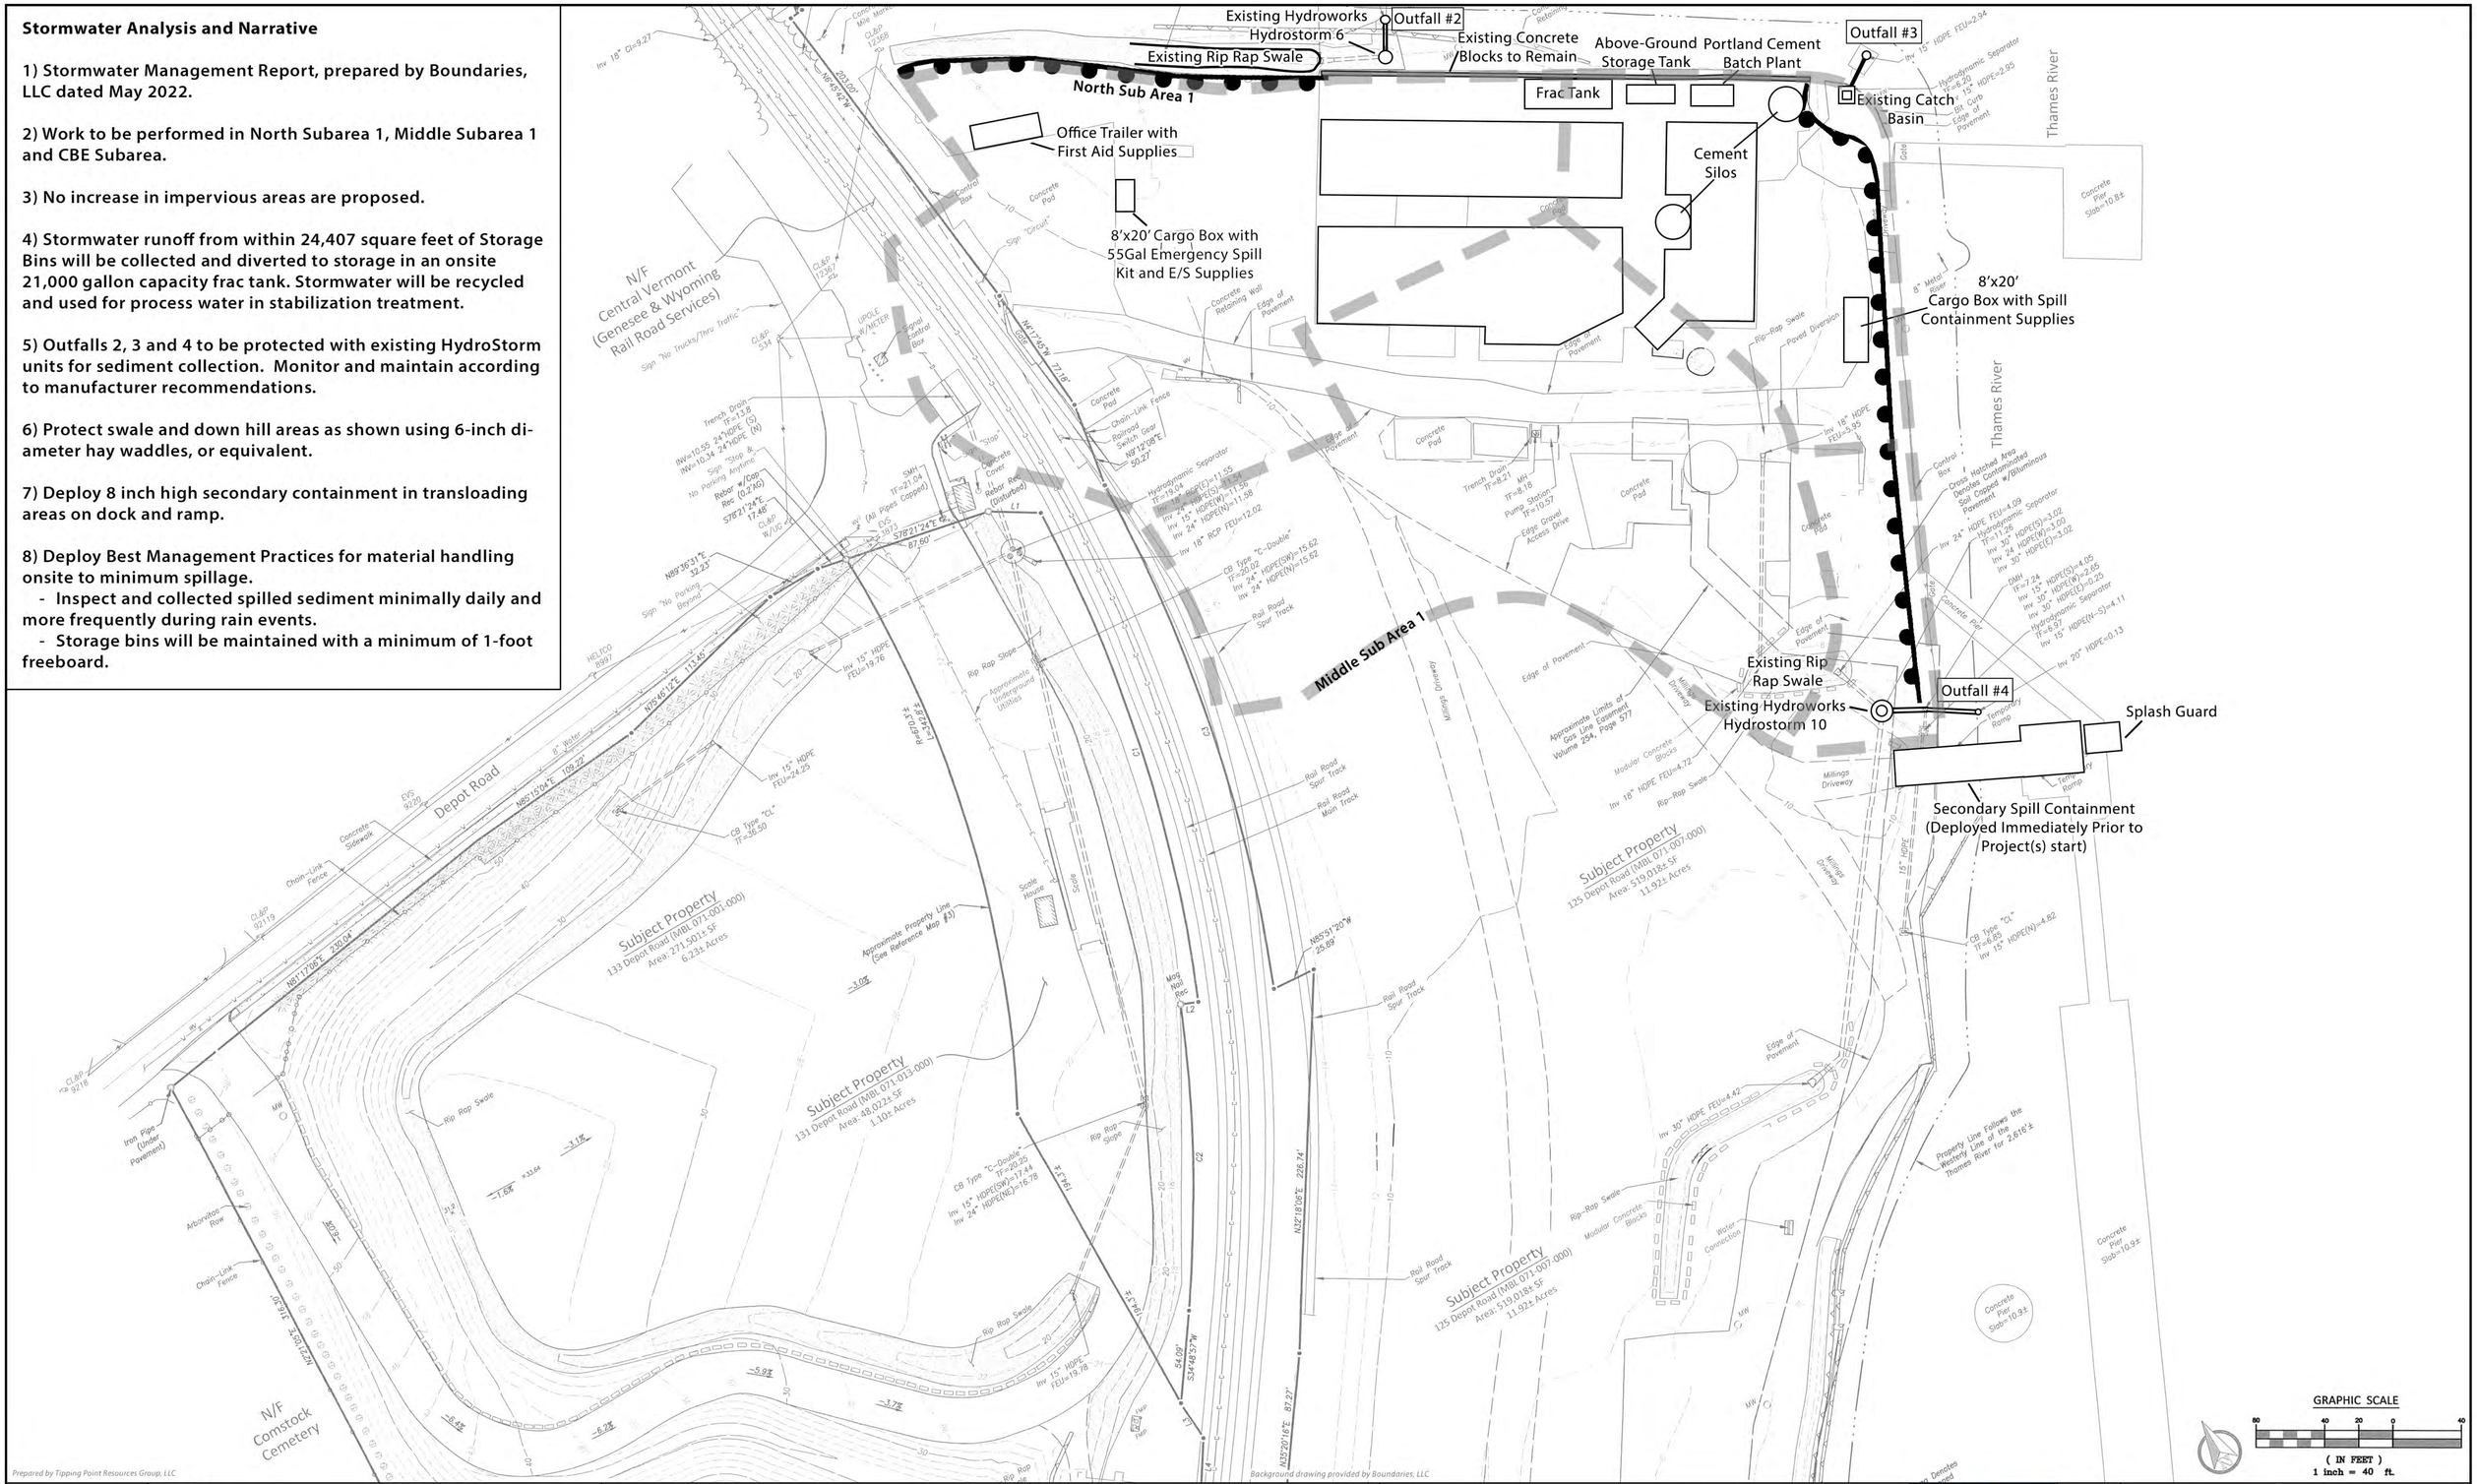

Date	Legend	General Notes		Erosions & Sedimentation Control, Spill Prevention and Safety Plan Detail		
07 September 2023	Waddles	Best Management Practices	No increase in impervious area		Alfred N. Rovoli, P.E., LEP, ELAP	19765 / License NO. / 04 September2023 / DATE
Version	Subdrainage Basins Onsite per Boundaries 2022 Survey	1) Housekeeping	No change in the grades			
1.7		2) Hay bales and silt fence	Stormwater and water inside basins to be collected into 20kGal frac tank			
Scale		3) Separators				
1"=40'		4) Collecting Stormwater that goes into bins				

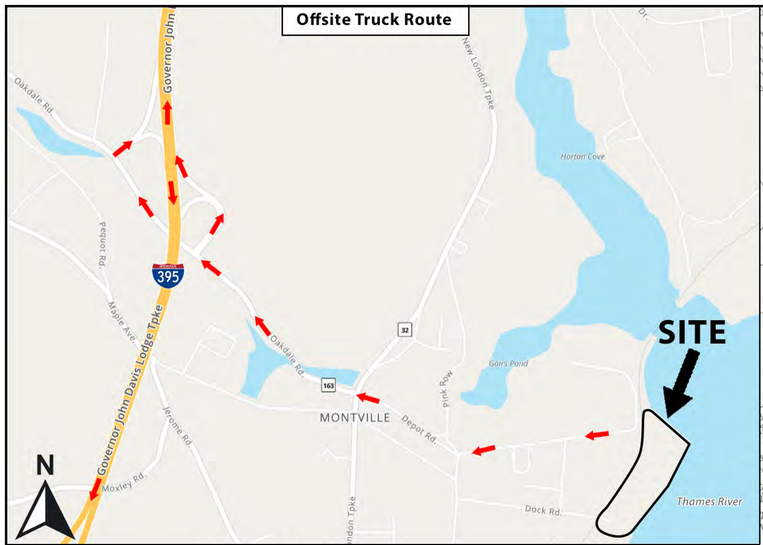

Traffic Summary: Truck Trips

Sand and Salt Existing Approval			Marine Materials Management Proposal			Combined Site Proposal	
Daily Ave	Daily Peak	Hourly Peak (summer/winter)	Daily Ave	Daily Peak	Hourly Peak	**Daily Peak**	**Hourly Peak (winter)**
148	448	30/62	182	240	30	**688**	**92**

Source: F. A. Hesketh & Associates, Inc., East Granby, CT. December 15, 2022

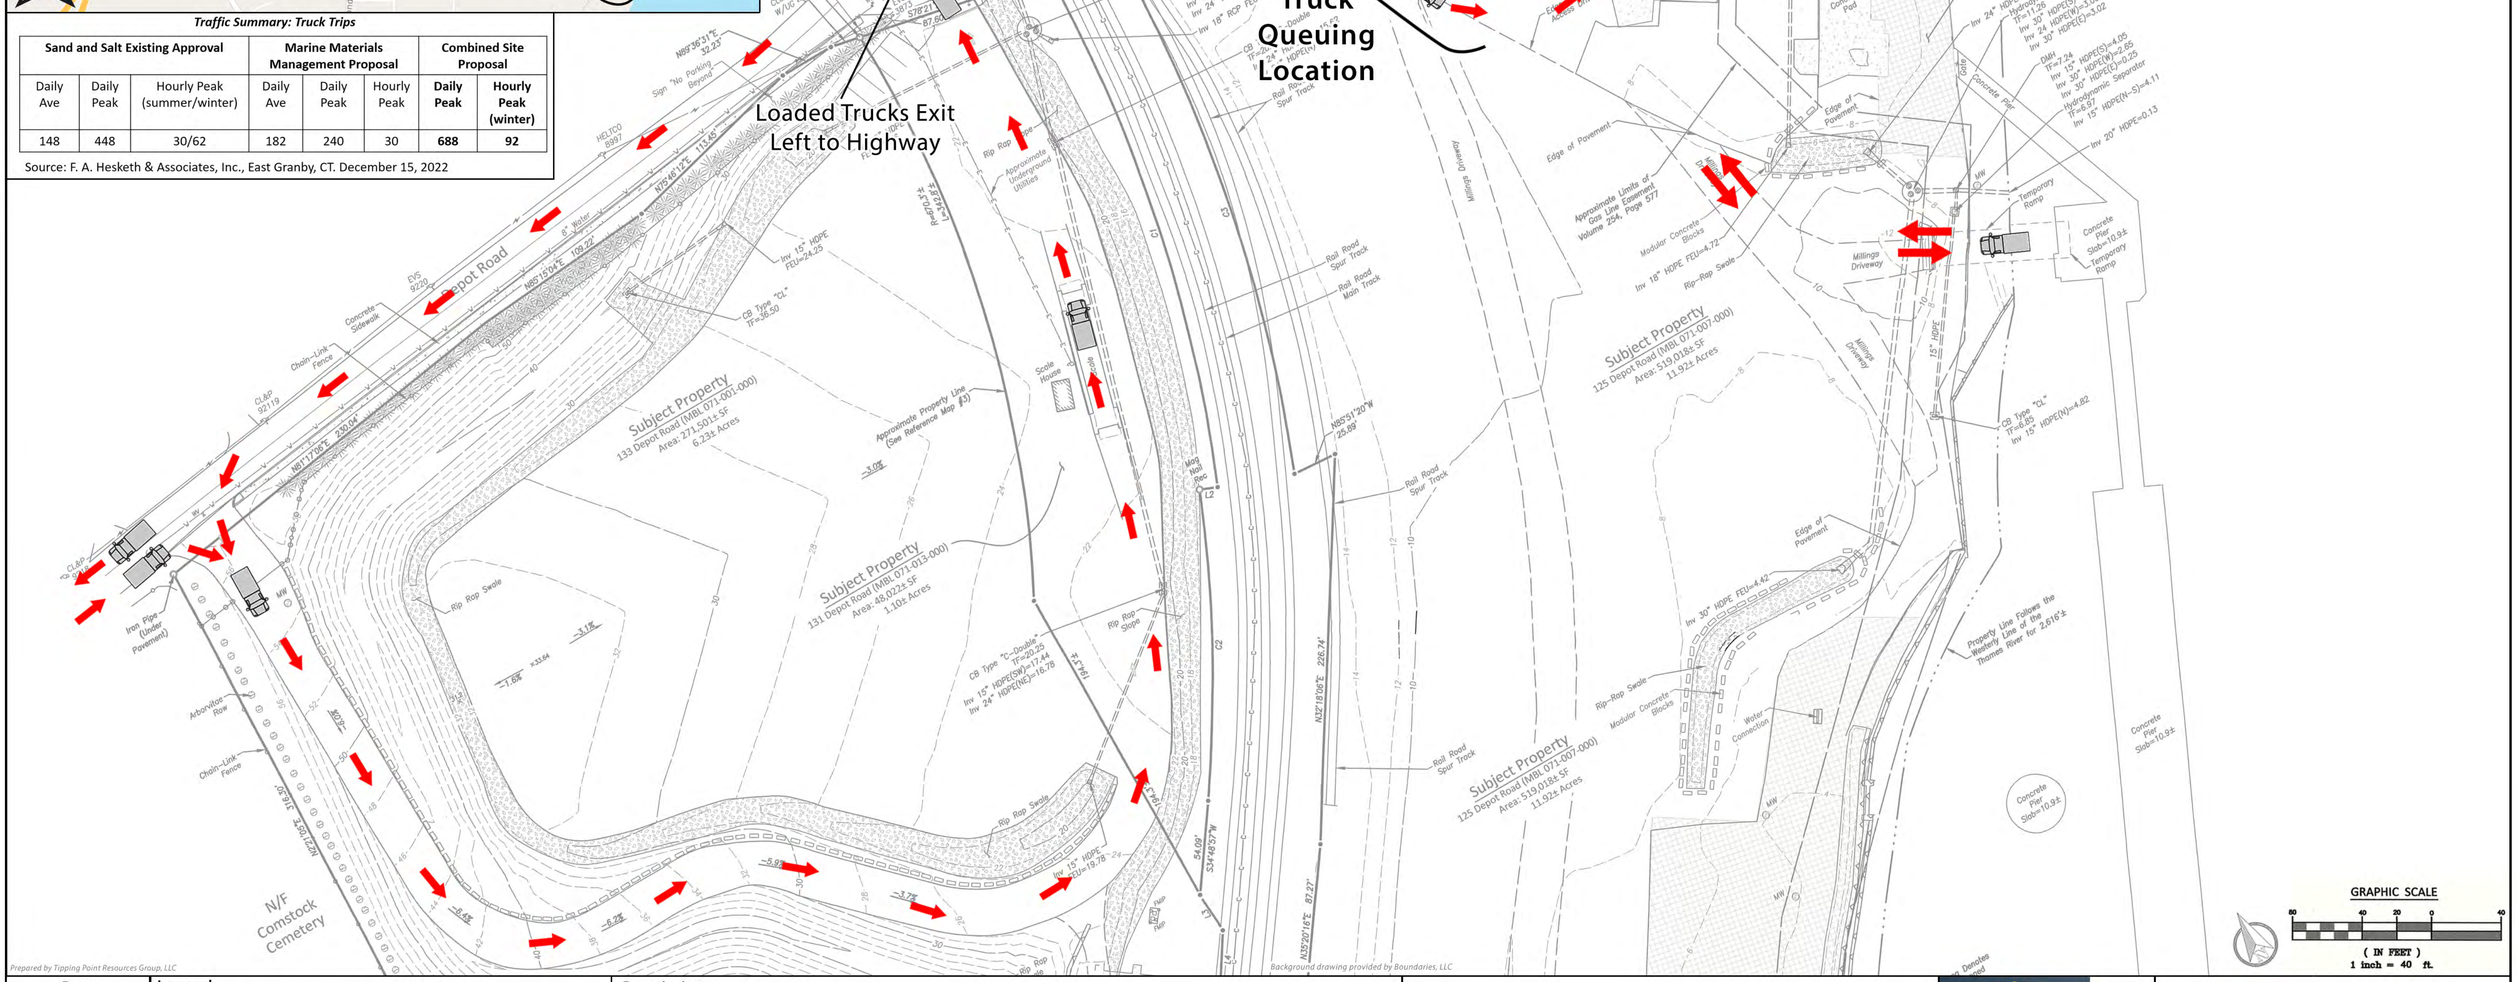

Prepared by Tipping Point Resources Group, LLC

Background drawing provided by Boundaries, LLC

Date	Legend	Description
11 September 2023	Onsite Heavy Equipment Triaxle Offloading and Transfer Option (Water-tight trucks to be fitted with noise reducing impact damper on tailgates)	22 Ton Tri-Axle Dump Trucks will transport engineered fill off-site via Depot Rd. Trucks will enter the property via Depot Road and continue east to the designated queueing area. Trucks will then proceed to the South side of the Engineered Fill Storage Area to be loaded by a Material Handler. Loaded trucks will exit the property West-bound via Depot Rd.
Version 1.5	Onsite/Offsite Vehicle Transportation Route	
Scale 1"=40'		

Traffic Plan Detail

M3 MARINE MATERIALS MANAGEMENT

TIPPING POINT RESOURCES GROUP



Signage Legend

1

02'

MARINE MATERIALS MANAGEMENT
Thames River
125 Depot Road
Uncasville, CT

M3

All PPE Required, Visitors check in at office

06'

Date
12 September 2023
Version
1.6
Scale
1"=40'

Lighting Legend

E — Emergency Lighting with Backup Power, Vertical Mast Lighting Tower (typ, 6kW - Diesel)

Vertical Mast Lighting Tower (typ, 6kW - Diesel)

General Notes

All lights shall be directed downward to work area, minimizing spill and disruption to neighboring properties.

Lights shall be used as necessary during permitted working hours only.

Lighting and Signage Plan Detail

M3 MARINE MATERIALS MANAGEMENT

TIPPING POINT RESOURCES GROUP


