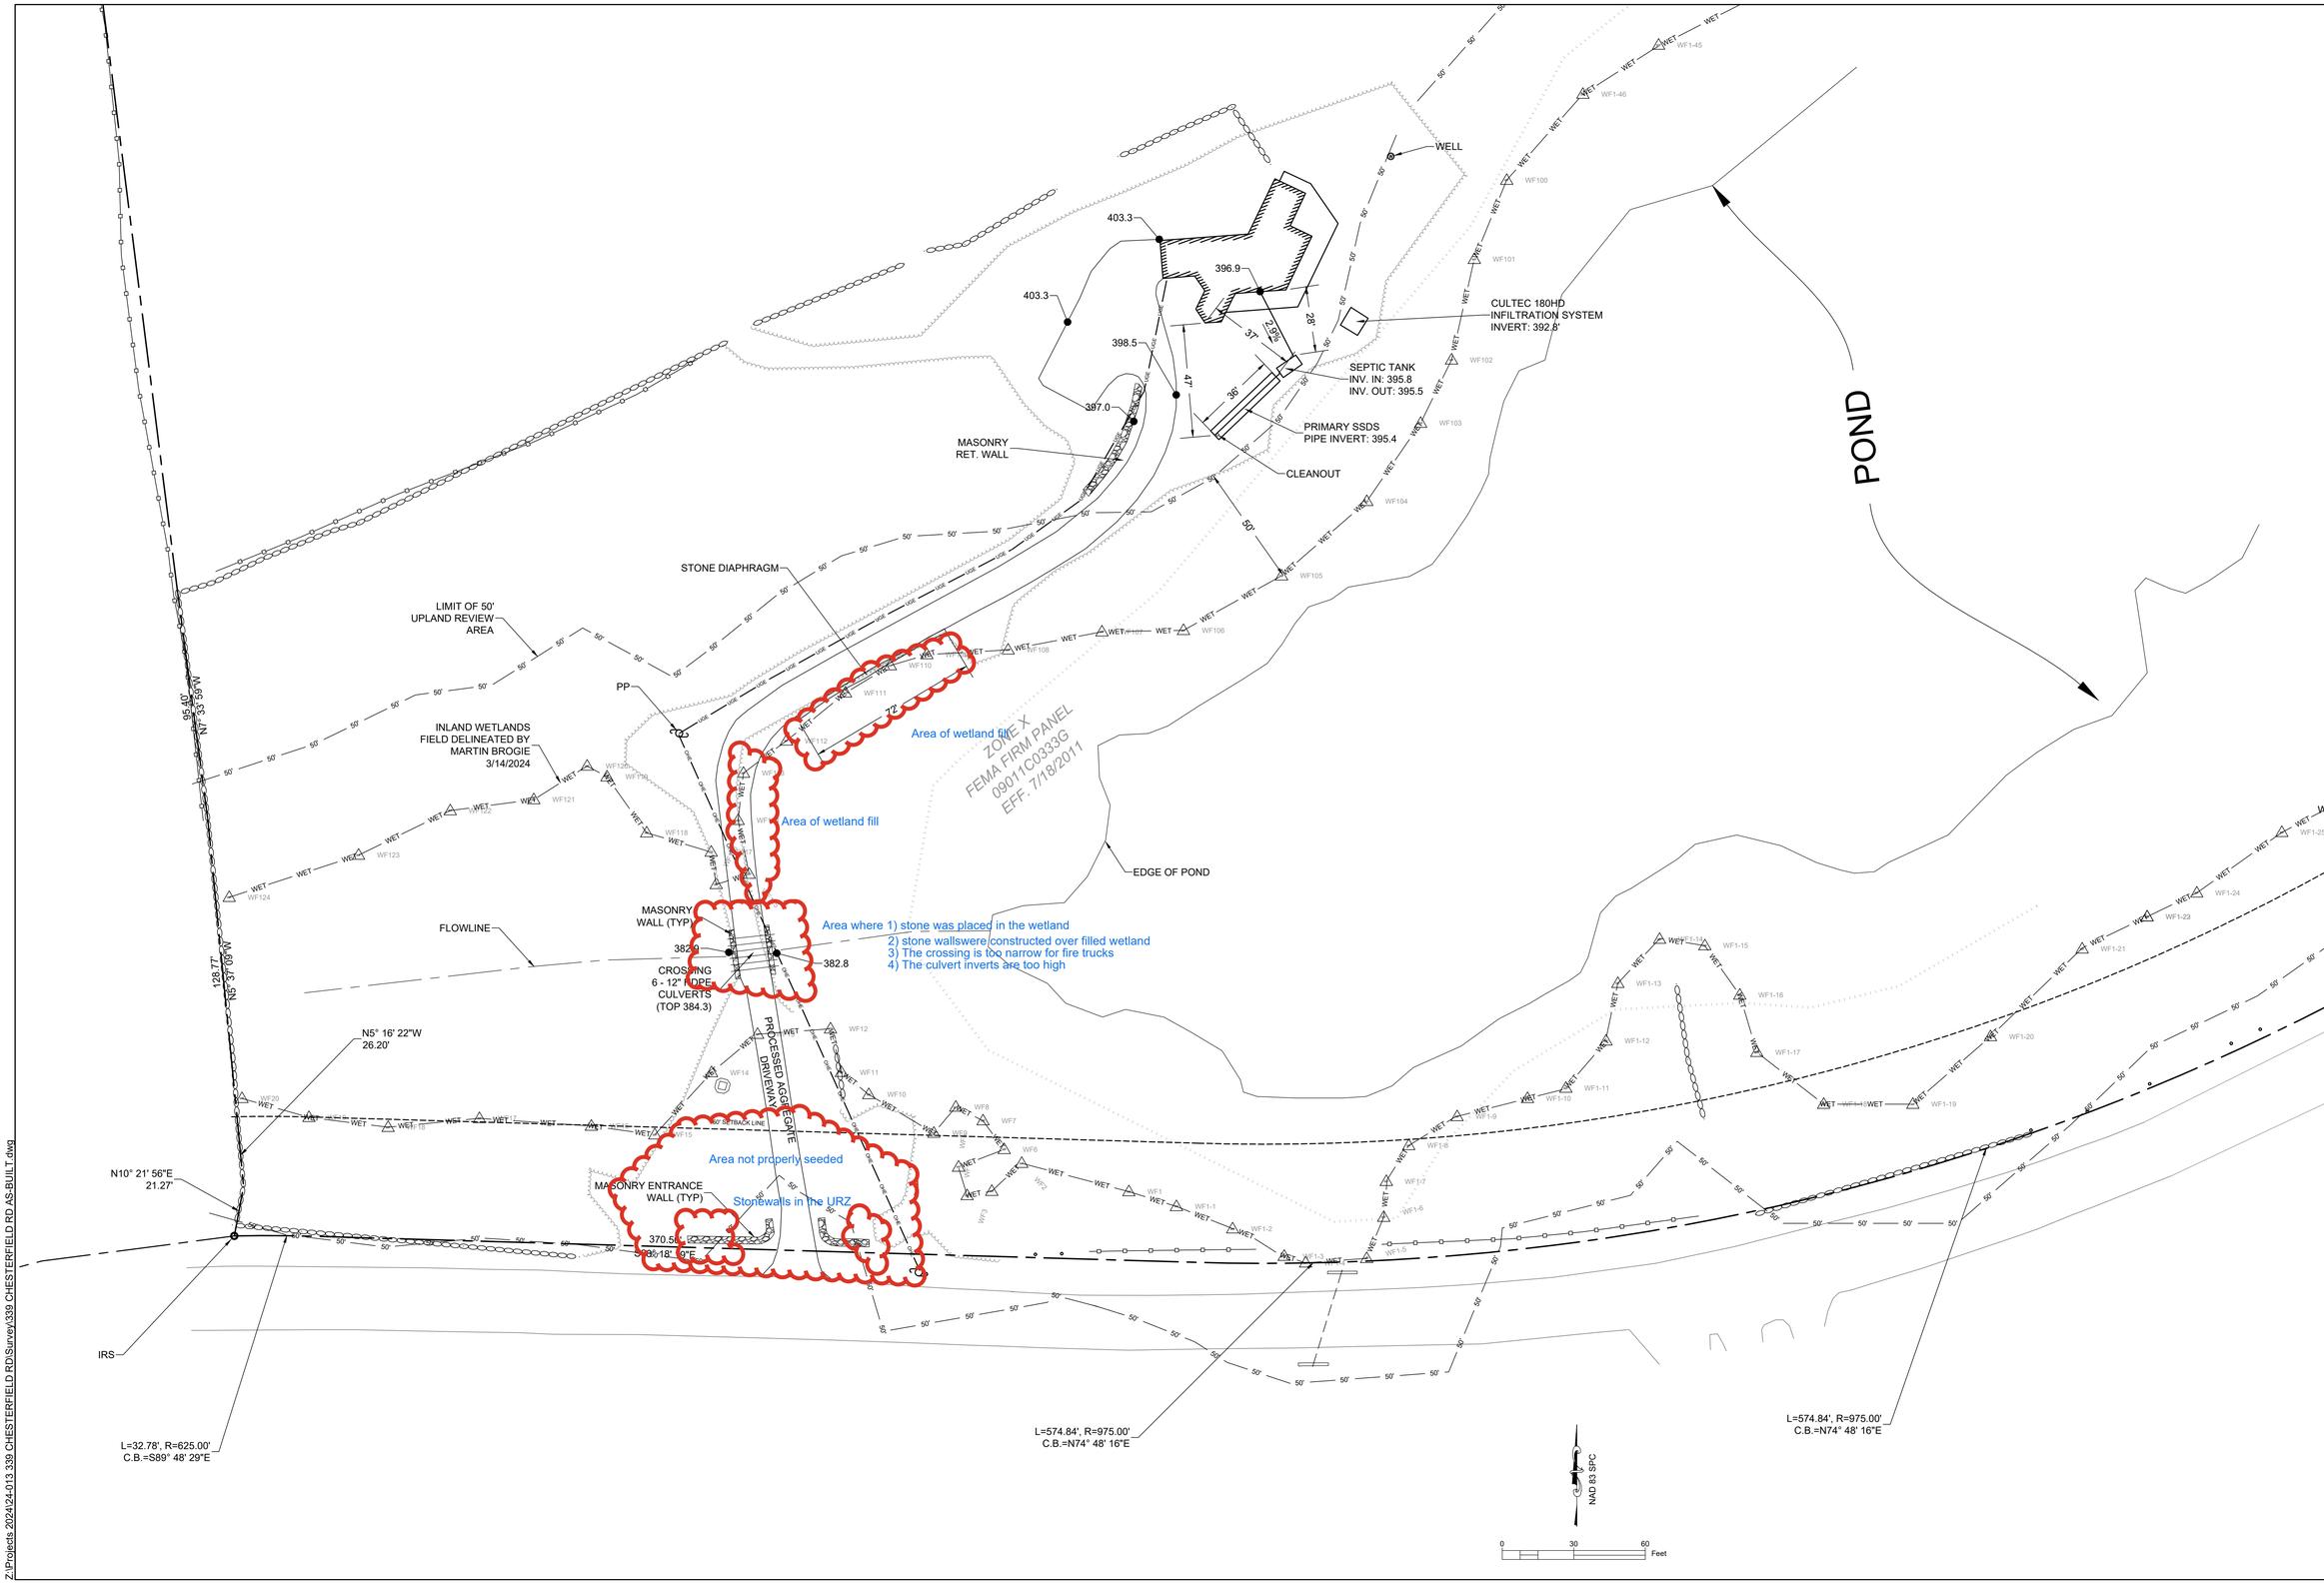

Z:\Projects 2024\24-013 339 CHESTERFIELD RD\Survey\339 CHESTERFIELD RD AS-BUILT.dwg

V-102

SHEET

LEGEND:

CHD -	CONN. HIGHWAY MON.
MS -	MERESTONE
CMF -	CONC. MON. FOUND
CMS -	CONC. MON. SET
SMF-	STONE MON. FOUND
IRF -	IRON REBAR FOUND
IRS -	IRON REBAR SET
IPF -	IRON PIPE FOUND
PKS -	PK NAIL SET
PKF -	PK NAIL FOUND
DHS -	DRILL HOLE SET
DHF -	DRILL HOLE FOUND
*WCAP -	WITH CAP

N 90° 00' 00" E	PROPERTY LINE
20' SETBACK LINE	BRL (SETBACK)
	EASEMENT
	FENCE
OHE	OVERHEAD ELECTRICAL LINE
UGE	UNDERGROUND ELECTRICAL LINE
W	WATER PIPE
	STORM PIPE
190	MAJOR CONTOUR
	MINOR CONTOUR
	STONE WALL
	POWER POLE
	WATER METER
	CATCH BASIN

TITLE:

RECORD IMPROVEMENT LOCATION MAP

339 CHESTERFIELD RD
OAKDALE, CT

DRAWING SCALE: 1" = 30'

DATE: DEC 10, 2025

PREPARED BY:

RCL THOMPSON LLC

ENGINEERING - SURVEYING
860-941-7721
www.rclthompson.com

19 Pepperbush Dr.
Clinton, CT 06413

TO MY KNOWLEDGE AND BELIEF, THIS MAP IS SUBSTANTIALLY CORRECT AS NOTED HEREON.

STATE OF CONNECTICUT
RYAN E. THOMPSON
L.S. 29817
LICENSED LAND SURVEYOR

RYAN E. THOMPSON PEL 29817

REVISIONS